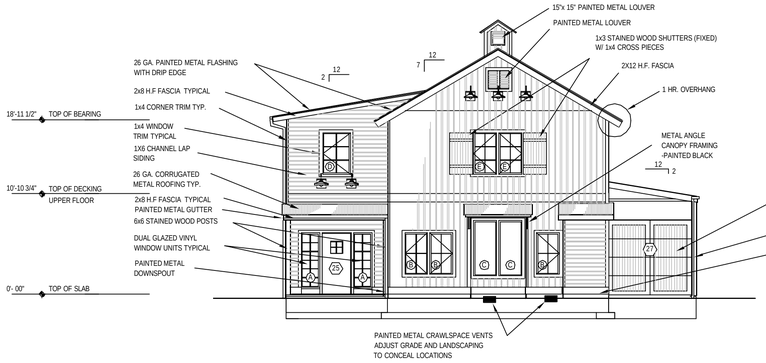

ENTRY ELEVATION (east)

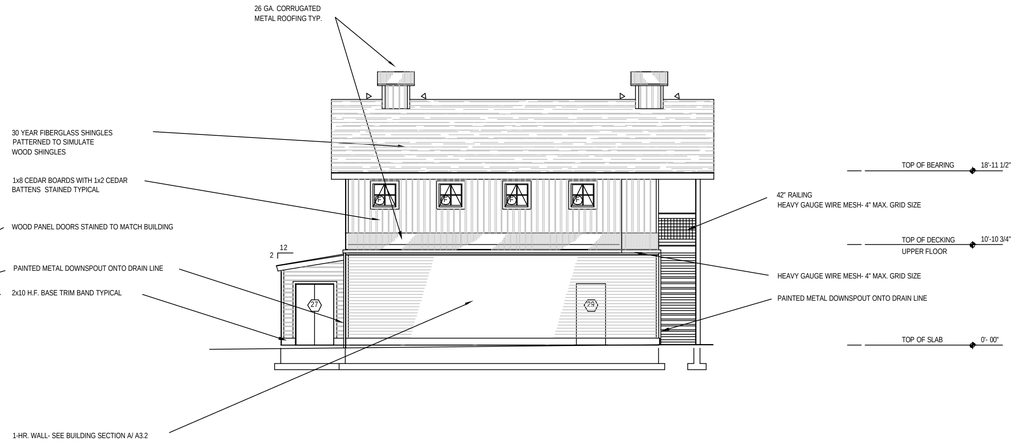

RIGHT SIDE ELEVATION (north)

WINDOW SCHEDULE

MILGARD VINYL WINDOW SYSTEMS -WHITE CLASSIC

SYM.	SIZE	TYPE	COMMENTS
A	2060	FIXED	MULLIONS AS PER ELEVATIONS TEMPERED
B	2646	CASEMENT	MULLIONS AS PER ELEVATIONS
C	2660	FIXED	
D	3046	CASEMENT	MULLIONS AS PER ELEVATIONS
E	2646	CASEMENT	MULLIONS AS PER ELEVATIONS
F	2626	AWNING	MULLIONS AS PER ELEVATIONS
G	3260	FIXED	MULLIONS AS PER ELEVATIONS TEMPERED
H	2060	FIXED	MULLIONS AS PER ELEVATIONS
I	6046	FIXED	MULLIONS AS PER ELEVATIONS

COMMENTS:

ALL GLAZING WILL BE INSTALLED WITH A CERTIFYING LABEL ATTACHED SHOWING THE U-VALUE

ELEVATION NOTES

1. ALL FLASHING FOR EXTERIOR OPENINGS, DECKS, CHIMNEYS AND ROOF TO WALL DETAILS SHALL BE 26 GA. GALV. SHEET METAL AS PER UBC.
2. PROVIDE DUPONT "TYVEK" HOUSEWRAP UNDER WOOD SIDING.
3. ALL ROOF COVERING SHALL CONFORM TO THE STANDARDS OF UBC AND SHALL BE FASTENED AS PER MANUFACTURER'S SPECIFICATIONS.
4. ALL WEATHER-EXPOSED SURFACES SHALL HAVE A WEATHER RESISTIVE BARRIER TO PROTECT THE INTERIOR WALL COVERING AND THAT EXTERIOR OPENINGS SHALL BE FLASHED IN SUCH A MANNER AS TO MAKE THEM WEATHERPROOF.

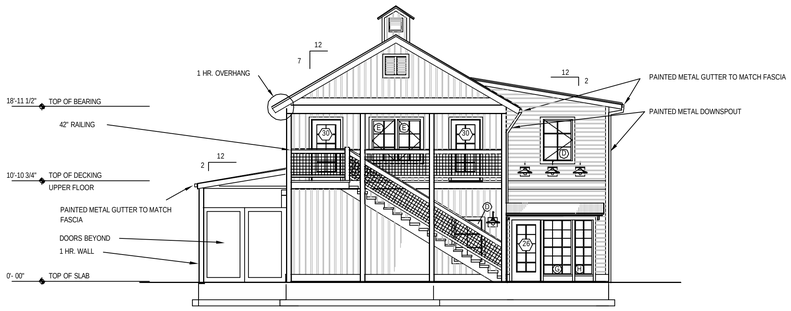

REAR ELEVATION (west)

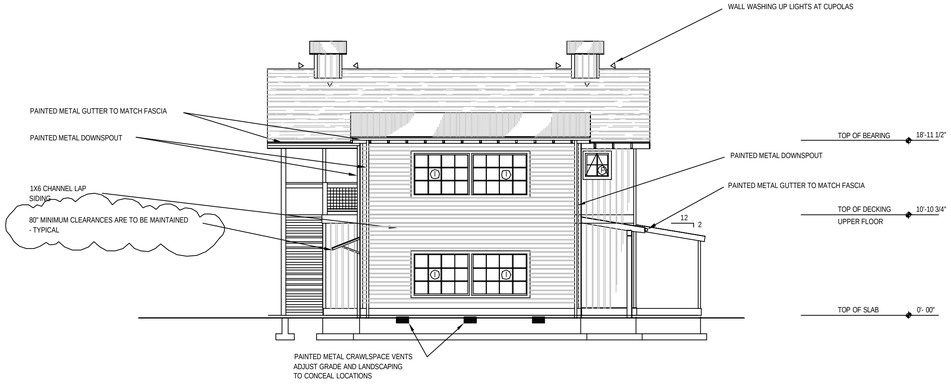

LEFT SIDE ELEVATION (south)

INSULATION SCHEDULE

ROOF TRUSSES: R-30" BATT INSULATION ROOF JOISTS: R-19 BATT INSULATION

WALLS- 4" R-15 BATT INSULATION 6" R-19 BATT INSULATION

UPPER LEVEL FLOOR FRAMING - 10" R-30 BATT INSULATION

LOWER LEVEL FLOOR FRAMING - 10" R-30 BATT INSULATION

ALL EXPOSED SIMPSON COLUMN CONNECTORS TO BE ORDERED GREY AND PAINTED SATIN BLACK

SHOP ELEVATIONS

1/8"= 1'-0"

Consultants:

DANNY F. HORN- Land Surveyor
CONTACT: Danny Horn
655 Spring Street
Paso Robles, CA 93446
805 239-0355 fax: 805 239-1349

CENTRAL COAST ENERGY COMPLIANCE
CONTACT: Michelle Dunn
489 Mar Vista Drive
Los Osos, CA 93402
office and fax: 805 528-2754

KEN HARVEY
architectural
studio
P.O. BOX 287 CAYUCOS, CA 93430 805 995-2641

These drawings are instruments of service and are the property of KEN HARVEY ARCHITECTURAL STUDIO. All designs and other information on the drawings are for the use on the specified project and shall not be used without the expressed written consent of KEN HARVEY ARCHITECTURAL STUDIO.

Project:

CAMBRIA GARDEN AND ARTS
PHASE 2 SHOPS
CAMBRIA, CA 93428

Revisions:

REVIEW SET	10-15-02
BLDG. PERMIT SUBMITTAL	01-30-03
1ST PLAN CHECK RESPONSE	03-30-04
PERMIT RELEASE SET	10-11-04

Sheet Contents:

SHOP ELEVATIONS

Sheet Number:

A2.2